



P:\18\181180\Drawings\Exhibits\Overlay Plans\181180a\17_R4-47_Overlays Rev 2020.03.23.dwg (05-Site B, 10/08/2014, 4:28:00 PM, cadawic, Xerox510-5-pc3, User334, 13 89999997)

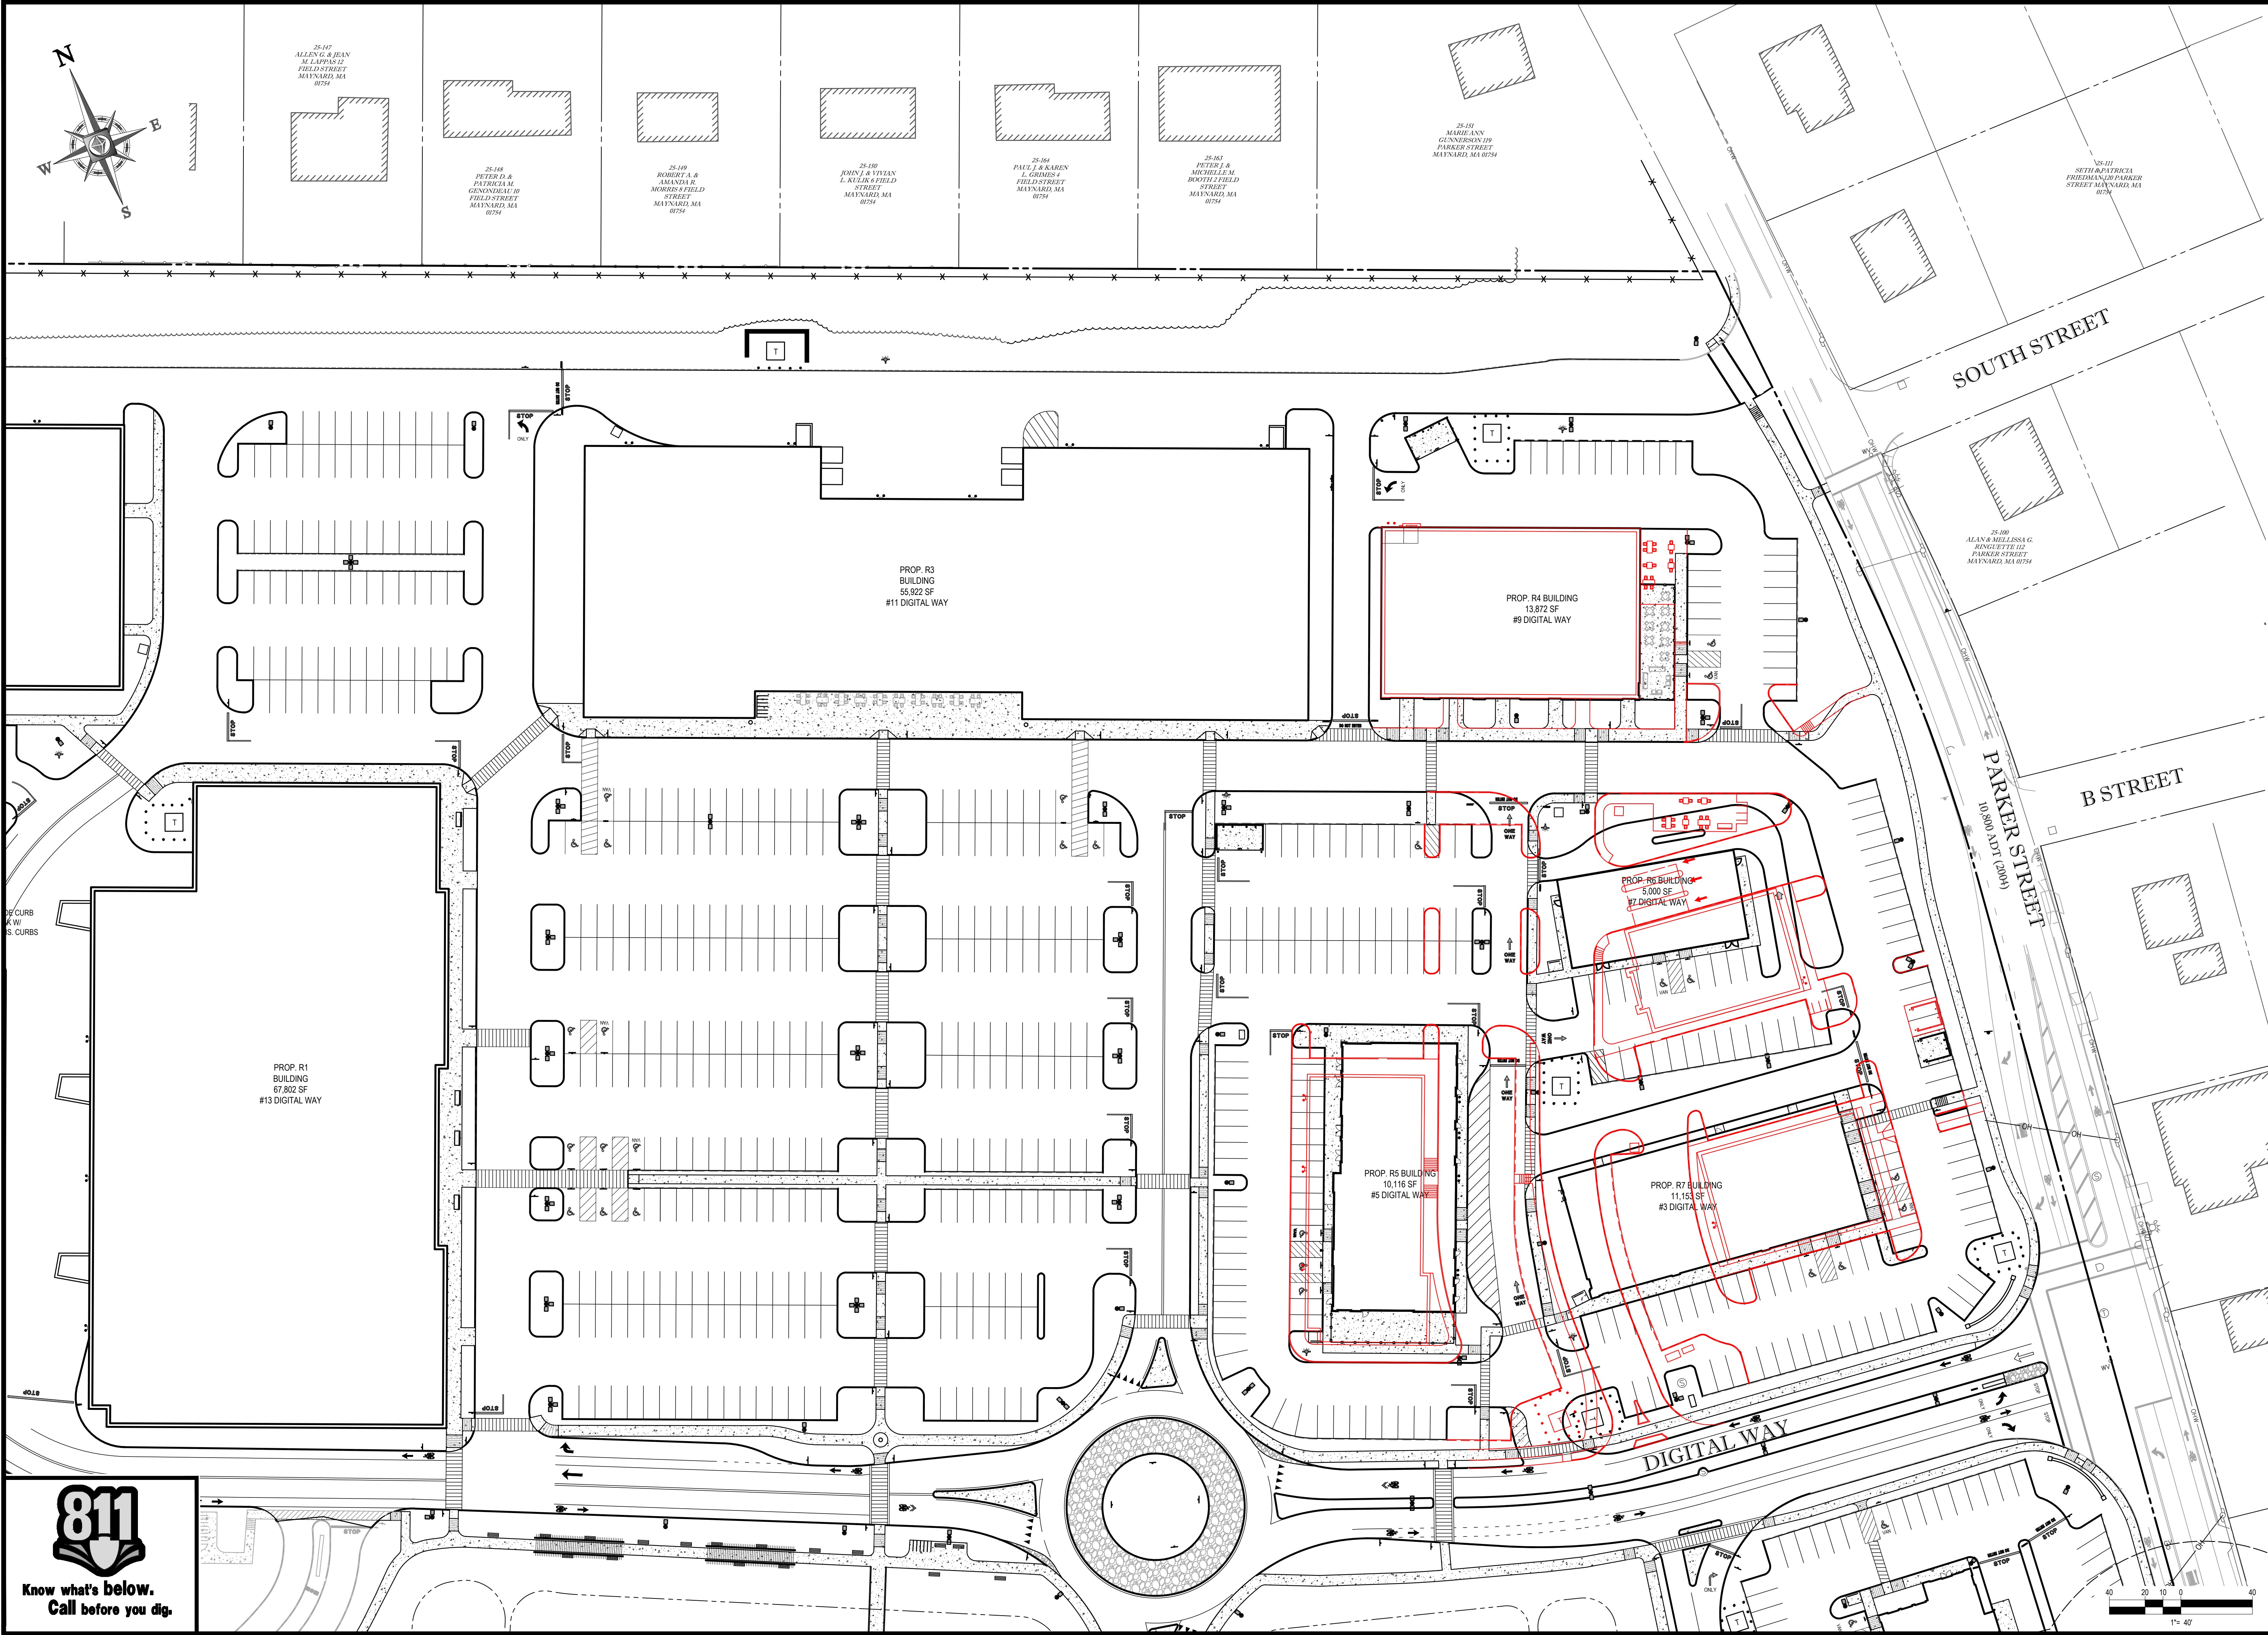

Know what's below.
Call before you dig.

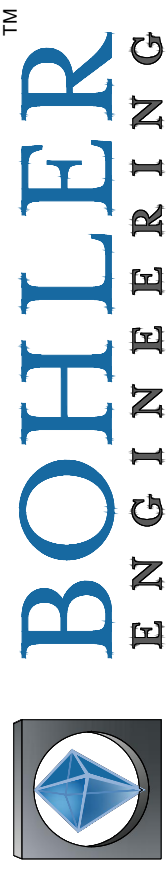

BOHLER ENGINEERING
SITE PLANS AND CONSTRUCTION DOCUMENTS
LAND SURVEYING PROGRAM MANAGEMENT LANDSCAPE ARCHITECTURE
SUSTAINABLE DESIGN PERMITTING SERVICES TRANSPORTATION SERVICES
UPSTATE NEW YORK
• ALBANY, NY
• BOSTON, MA
• NEW YORK, NY
• NEW JERSEY, NJ
• SOUTH CAROLINA, SC
• SOUTH DAKOTA, SD
• TEXAS, TX
• VIRGINIA, VA
• WISCONSIN, WI
• ILLINOIS, IL
• INDIANA, IN
• KANSAS, KS
• MICHIGAN, MI
• MINNESOTA, MN
• MISSOURI, MO
• NEBRASKA, NE
• NORTH CAROLINA, NC
• OHIO, OH
• OKLAHOMA, OK
• PENNSYLVANIA, PA
• RHODE ISLAND, RI
• TENNESSEE, TN
• UTAH, UT
• VERMONT, VT
• WASHINGTON, WA
• WEST VIRGINIA, WV
• WYOMING, WY

REVISIONS			
REV	DATE	COMMENT	BY
5	07/26/17	REV. PER TOWN COMMENTS	AWP
6	08/10/17	PEER REVIEW COMMENTS	CFD
7	09/18/17	CONSTRUCTION DOCUMENTS	AWP
8	11/06/18	REVISED R9 / R10 PAD	CFD
9	12/10/18	REV. PER TOWN COMMENTS	CFD
10	04/23/19	REVISED R9 / R10 PAD	CMC
10A	05/13/19	REVISED PER TOWN COMMENTS	CFD
10B	07/25/19	REVISED PER TOWN COMMENTS	CMC
13	10/04/19	REVISED R4-R8 PAD	BPB
13A	11/12/19	REVISED MARKET BASKET LOADING AREA	BPB
13B	11/13/19	REVISED R8 PAD PER PB COMMENTS	BPB
13C	11/25/19	REVISED R8 PAD	BPB
13D	01/09/20	REVISED R8 PAD	BPB
15	01/16/20	REVISED R4-R7 PAD	BPB
16	01/31/20	REVISED R5 & R8 PAD	BPB
17	03/10/20	REVISED R5 & R7 PAD	CFD

PRELIMINARY

PROJECT No.: W161189
DRAWN BY: AWP/CFD
CHECKED BY: NEM/JAK
DATE: 02/19/2017
SCALE: AS NOTED
6/20/2017 R4-R7 OVERLAYS REV 2020.03.23

SITE DEVELOPMENT PLANS FOR



MAYNARD CROSSING

LOCATION OF SITE
MAP #25 & LOTS #152 & 152-1
129 PARKER STREET (ROUTE 27)
TOWN OF MAYNARD
MIDDLESEX COUNTY
MASSACHUSETTS



352 TURNPIKE ROAD
SOUTHBOROUGH, MA 01772
Phone: (508) 480-9900
Fax: (508) 480-9080
www.BohlerEngineering.com

J.A. KUCICH

PROFESSIONAL ENGINEER
MASSACHUSETTS LICENSE No. 41630
CONNECTICUT LICENSE No. 26177
RHODE ISLAND LICENSE No. 9616
MAINE LICENSE No. 12953

SHEET TITLE:

SITE PLAN "B"

SHEET NUMBER:
9
OF 37

REV 17 - 03/10/2020