


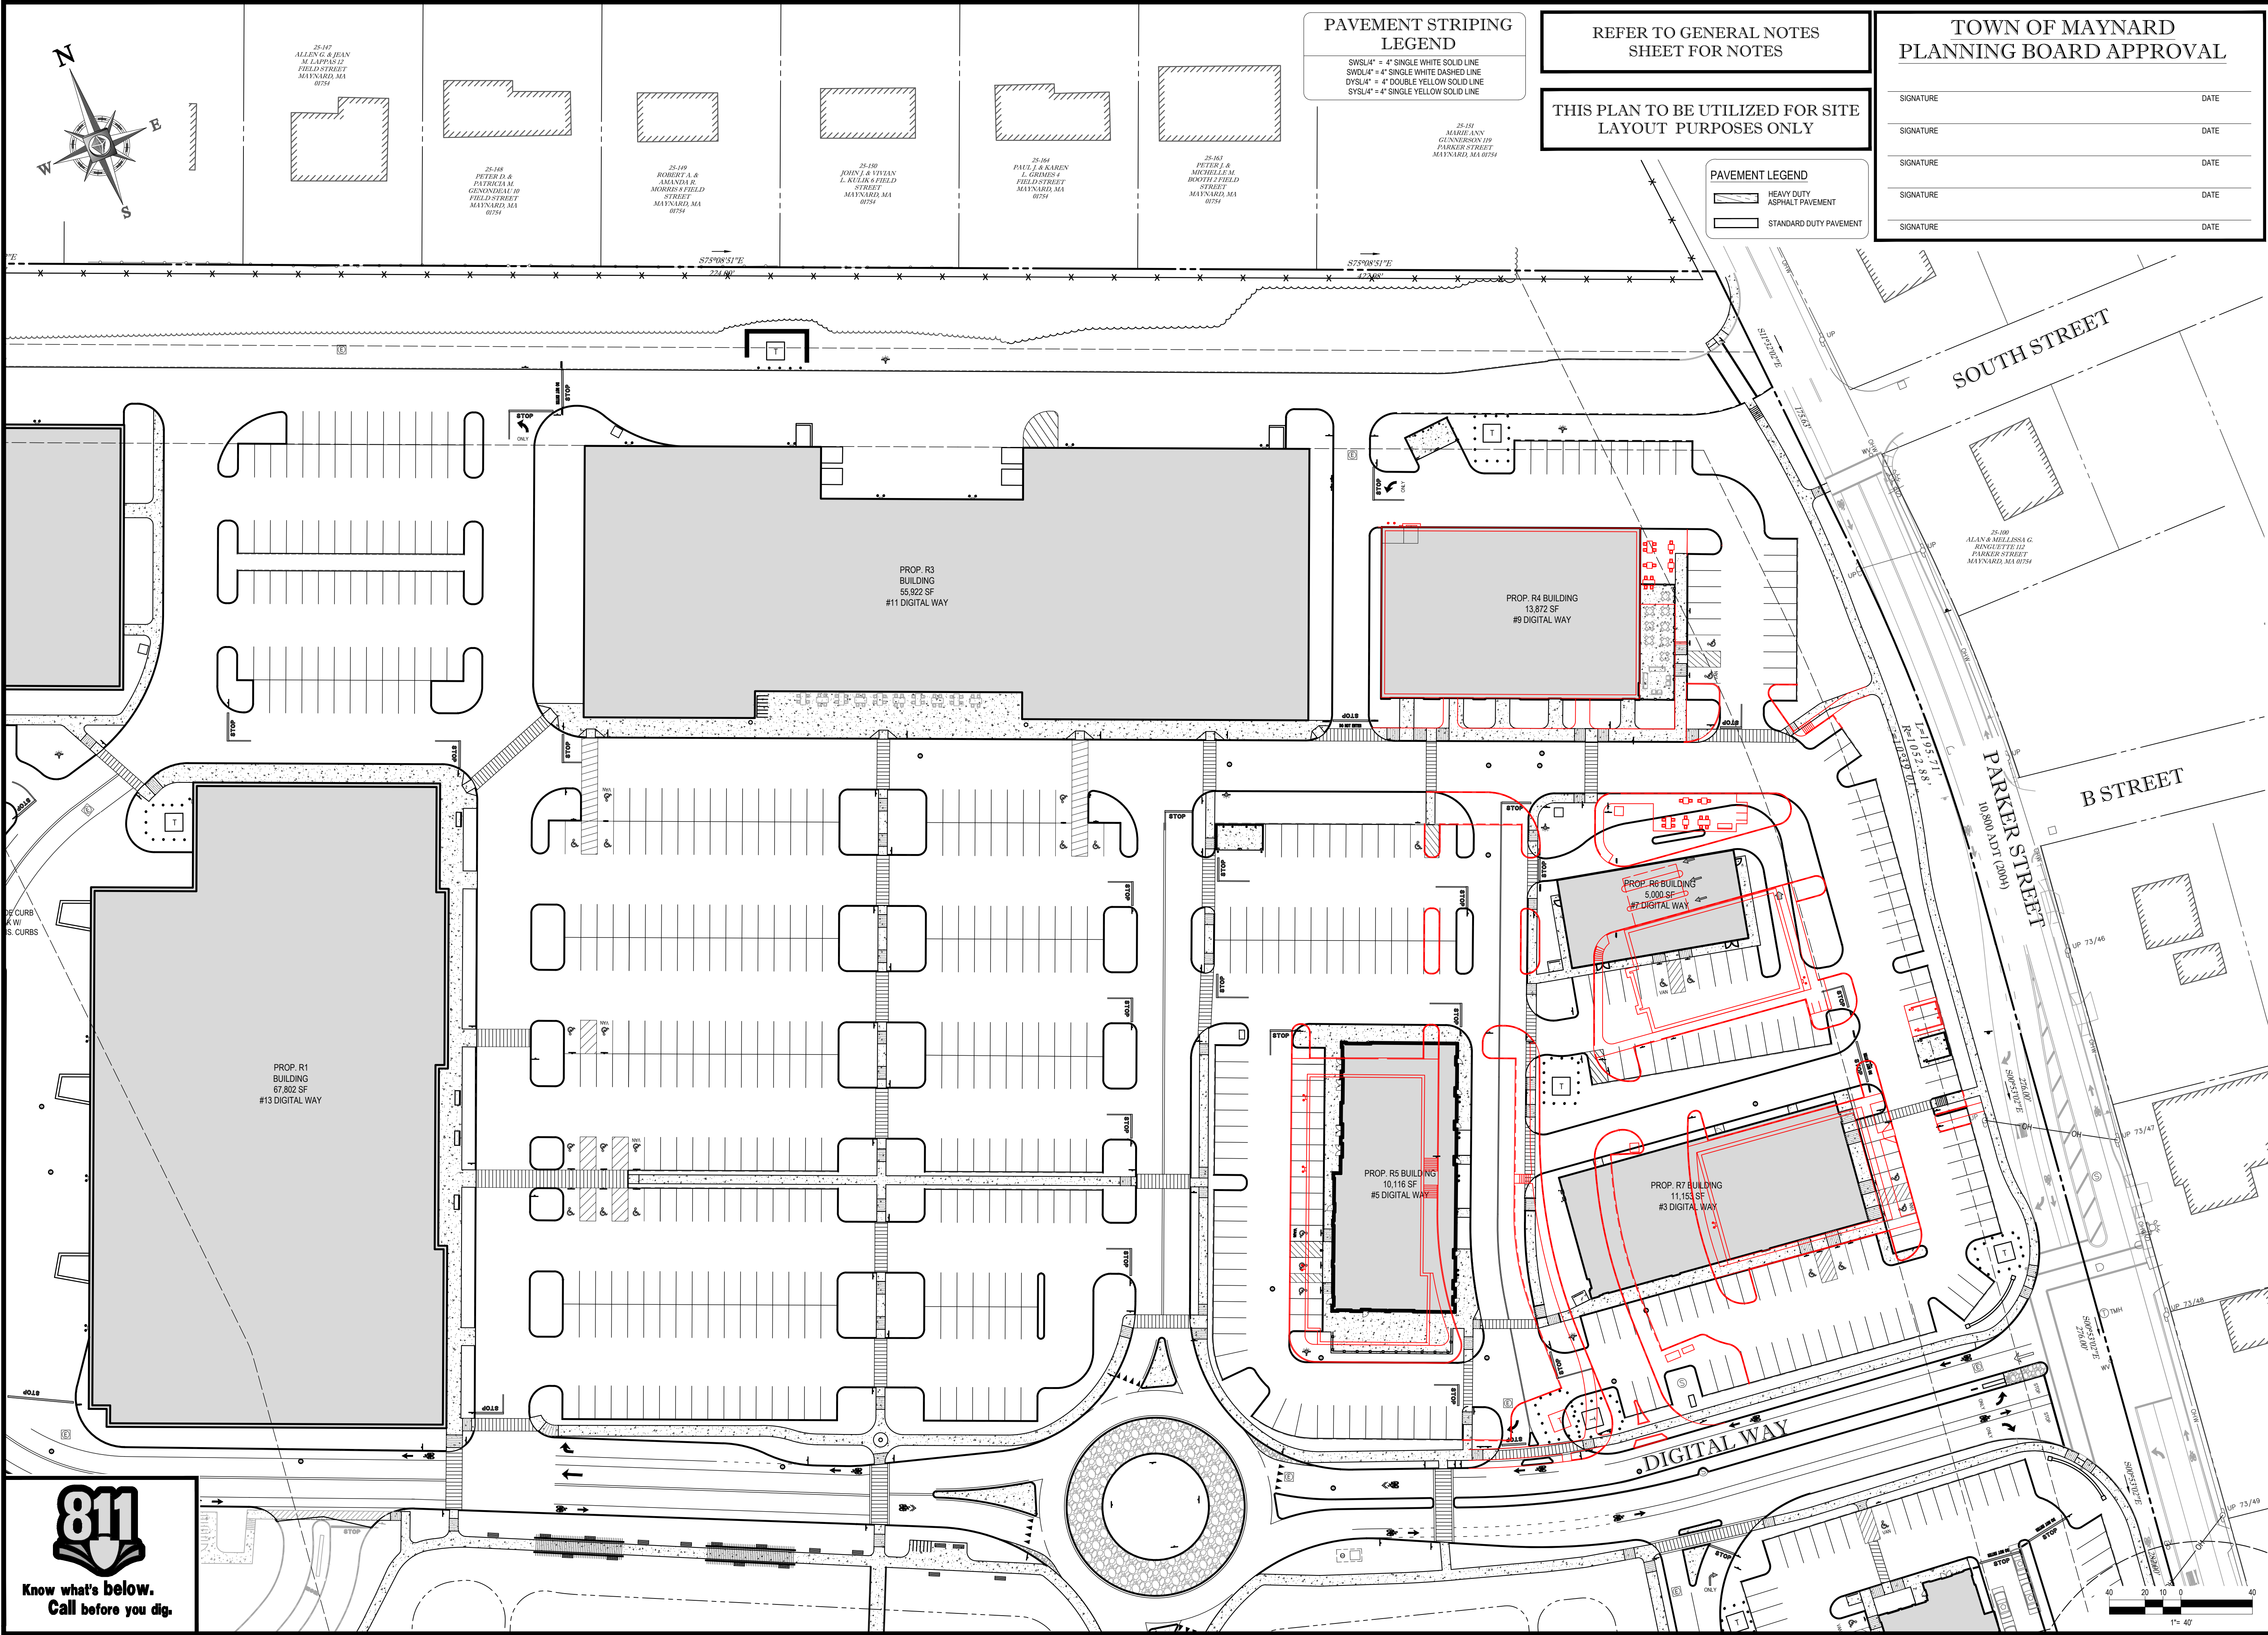

PAVEMENT STRIPING
LEGEND

SWSL/4" = 4" SINGLE WHITE SOLID LINE
SWDL/4" = 4" SINGLE WHITE DASHED LINE
DYSL/4" = 4" DOUBLE YELLOW SOLID LINE
SYSL/4" = 4" SINGLE YELLOW SOLID LINE

REFER TO GENERAL NOTES
SHEET FOR NOTES

THIS PLAN TO BE UTILIZED FOR SITE
LAYOUT PURPOSES ONLY

PAVEMENT LEGEND

HEAVY DUTY
ASPHALT PAVEMENT

STANDARD DUTY PAVEMENT

TOWN OF MAYNARD
PLANNING BOARD APPROVAL

SIGNATURE	DATE
SIGNATURE	DATE
BOHLER ENGINEERING

SITE PLANS, CONSTRUCTION DOCUMENTS, LANDSCAPE ARCHITECTURE, LAND SURVEYING, PROGRAM MANAGEMENT, TRANSPORTATION SERVICES, SUSTAINABLE DESIGN, PERMITTING SERVICES, TRANSPORTATION SERVICES

ALLEN G. & JUAN M. LAPPAS 12 FIELD STREET MAYNARD, MA 01954

PETER D. & PATRICIA M. GUNNDRON 10 FIELD STREET MAYNARD, MA 01954

ROBERT A. & AMANDA R. MORRIS 8 FIELD STREET MAYNARD, MA 01954

JOHN J. & VIVIAN L. KULKA 6 FIELD STREET MAYNARD, MA 01954

PAUL J. & KAREN L. GRIMES 4 FIELD STREET MAYNARD, MA 01954

PETER J. & MICHELLE M. BOOTH 2 FIELD STREET MAYNARD, MA 01954

MARIE ANN GUNNDRON 119 PARKER STREET MAYNARD, MA 01954

ALAN & MELISSA G. BONNETTE 102 PARKER STREET MAYNARD, MA 01954

UPSTATE NEW YORK
BOSTON, MA
NEW YORK, NY
NEW JERSEY, NJ
NORTHERN VIRGINIA
SOUTHERN MARYLAND
REHOBOTH BEACH, DE
ATLANTA, GA
PALM BEACH, FL
DALEBORO, MA
DALLAS, TX

THE INFORMATION CONTAINED HEREIN IS THE PROPERTY OF BOHLER ENGINEERING, INC. AND IS NOT TO BE REPRODUCED OR TRANSMITTED IN ANY FORM OR BY ANY MEANS, ELECTRONIC OR MECHANICAL, INCLUDING PHOTOCOPYING, RECORDING, OR BY ANY INFORMATION STORAGE AND RETRIEVAL SYSTEM, WITHOUT THE WRITTEN PERMISSION OF BOHLER ENGINEERING, INC.

REVISIONS			
REV	DATE	COMMENT	BY
1	03/21/17	REMOVE CARRIAGE BLDG. (SHEETS 8-12 ONLY)	CFD
2	06/02/17	REV. PER TOWN COMMENTS	CFD
3	06/15/17	DRAINAGE REVISIONS (SHEETS 13-16 ONLY)	GJZ
4	06/28/17	DRAINAGE REVISIONS (FULL SET)	AWP
5	07/26/17	REV. PER TOWN COMMENTS	AWP
6	08/10/17	PEER REVIEW COMMENTS	CFD
7	09/18/17	CONSTRUCTION DOCUMENTS	AWP
8	11/06/18	REVISED R9 / R10 PAD	CFD
9	12/10/18	REV. PER TOWN COMMENTS	CFD
10	04/23/19	REVISED R9 / R10 PAD	CMC
10A	05/13/19	REVISED PER TOWN COMMENTS	CFD
10B	07/25/19	REVISED PER TOWN COMMENTS	CMC
13	10/04/19	REVISED R4-R8 PAD	BPB
14	10/15/19	REVISED R8 PAD	BPB
15	11/11/19	REVISED R5 & R6 PAD	BPB

PRELIMINARY

PROJECT No.: W161189
DRAWN BY: AWP/CFD
CHECKED BY: NEM/JAK
DATE: 02/15/2017
SCALE: AS NOTED
W161189SSR4-R7 OVERLAYS REV 2019.11.19

PROJECT: **SITE DEVELOPMENT PLANS** FOR

CAPITAL GROUP PROPERTIES

MAYNARD CROSSING

LOCATION OF SITE
MAP #25 & LOTS #152 & 152-1
129 PARKER STREET (ROUTE 27)
TOWN OF MAYNARD
MIDDLESEX COUNTY
MASSACHUSETTS

BOHLER ENGINEERING

352 TURNPIKE ROAD
SOUTHBOROUGH, MA 01772
Phone: (508) 480-9900
Fax: (508) 480-9080
www.BohlerEngineering.com

J.A. KUCICH

PROFESSIONAL ENGINEER
MASSACHUSETTS LICENSE NO. 41630
CONNECTICUT LICENSE NO. 26177
RHODE ISLAND LICENSE NO. 9616
MAINE LICENSE NO. 12953

SHEET TITLE:
SITE PLAN "B"

SHEET NUMBER:
9
OF 36

REV 15 - 11/1/2019